
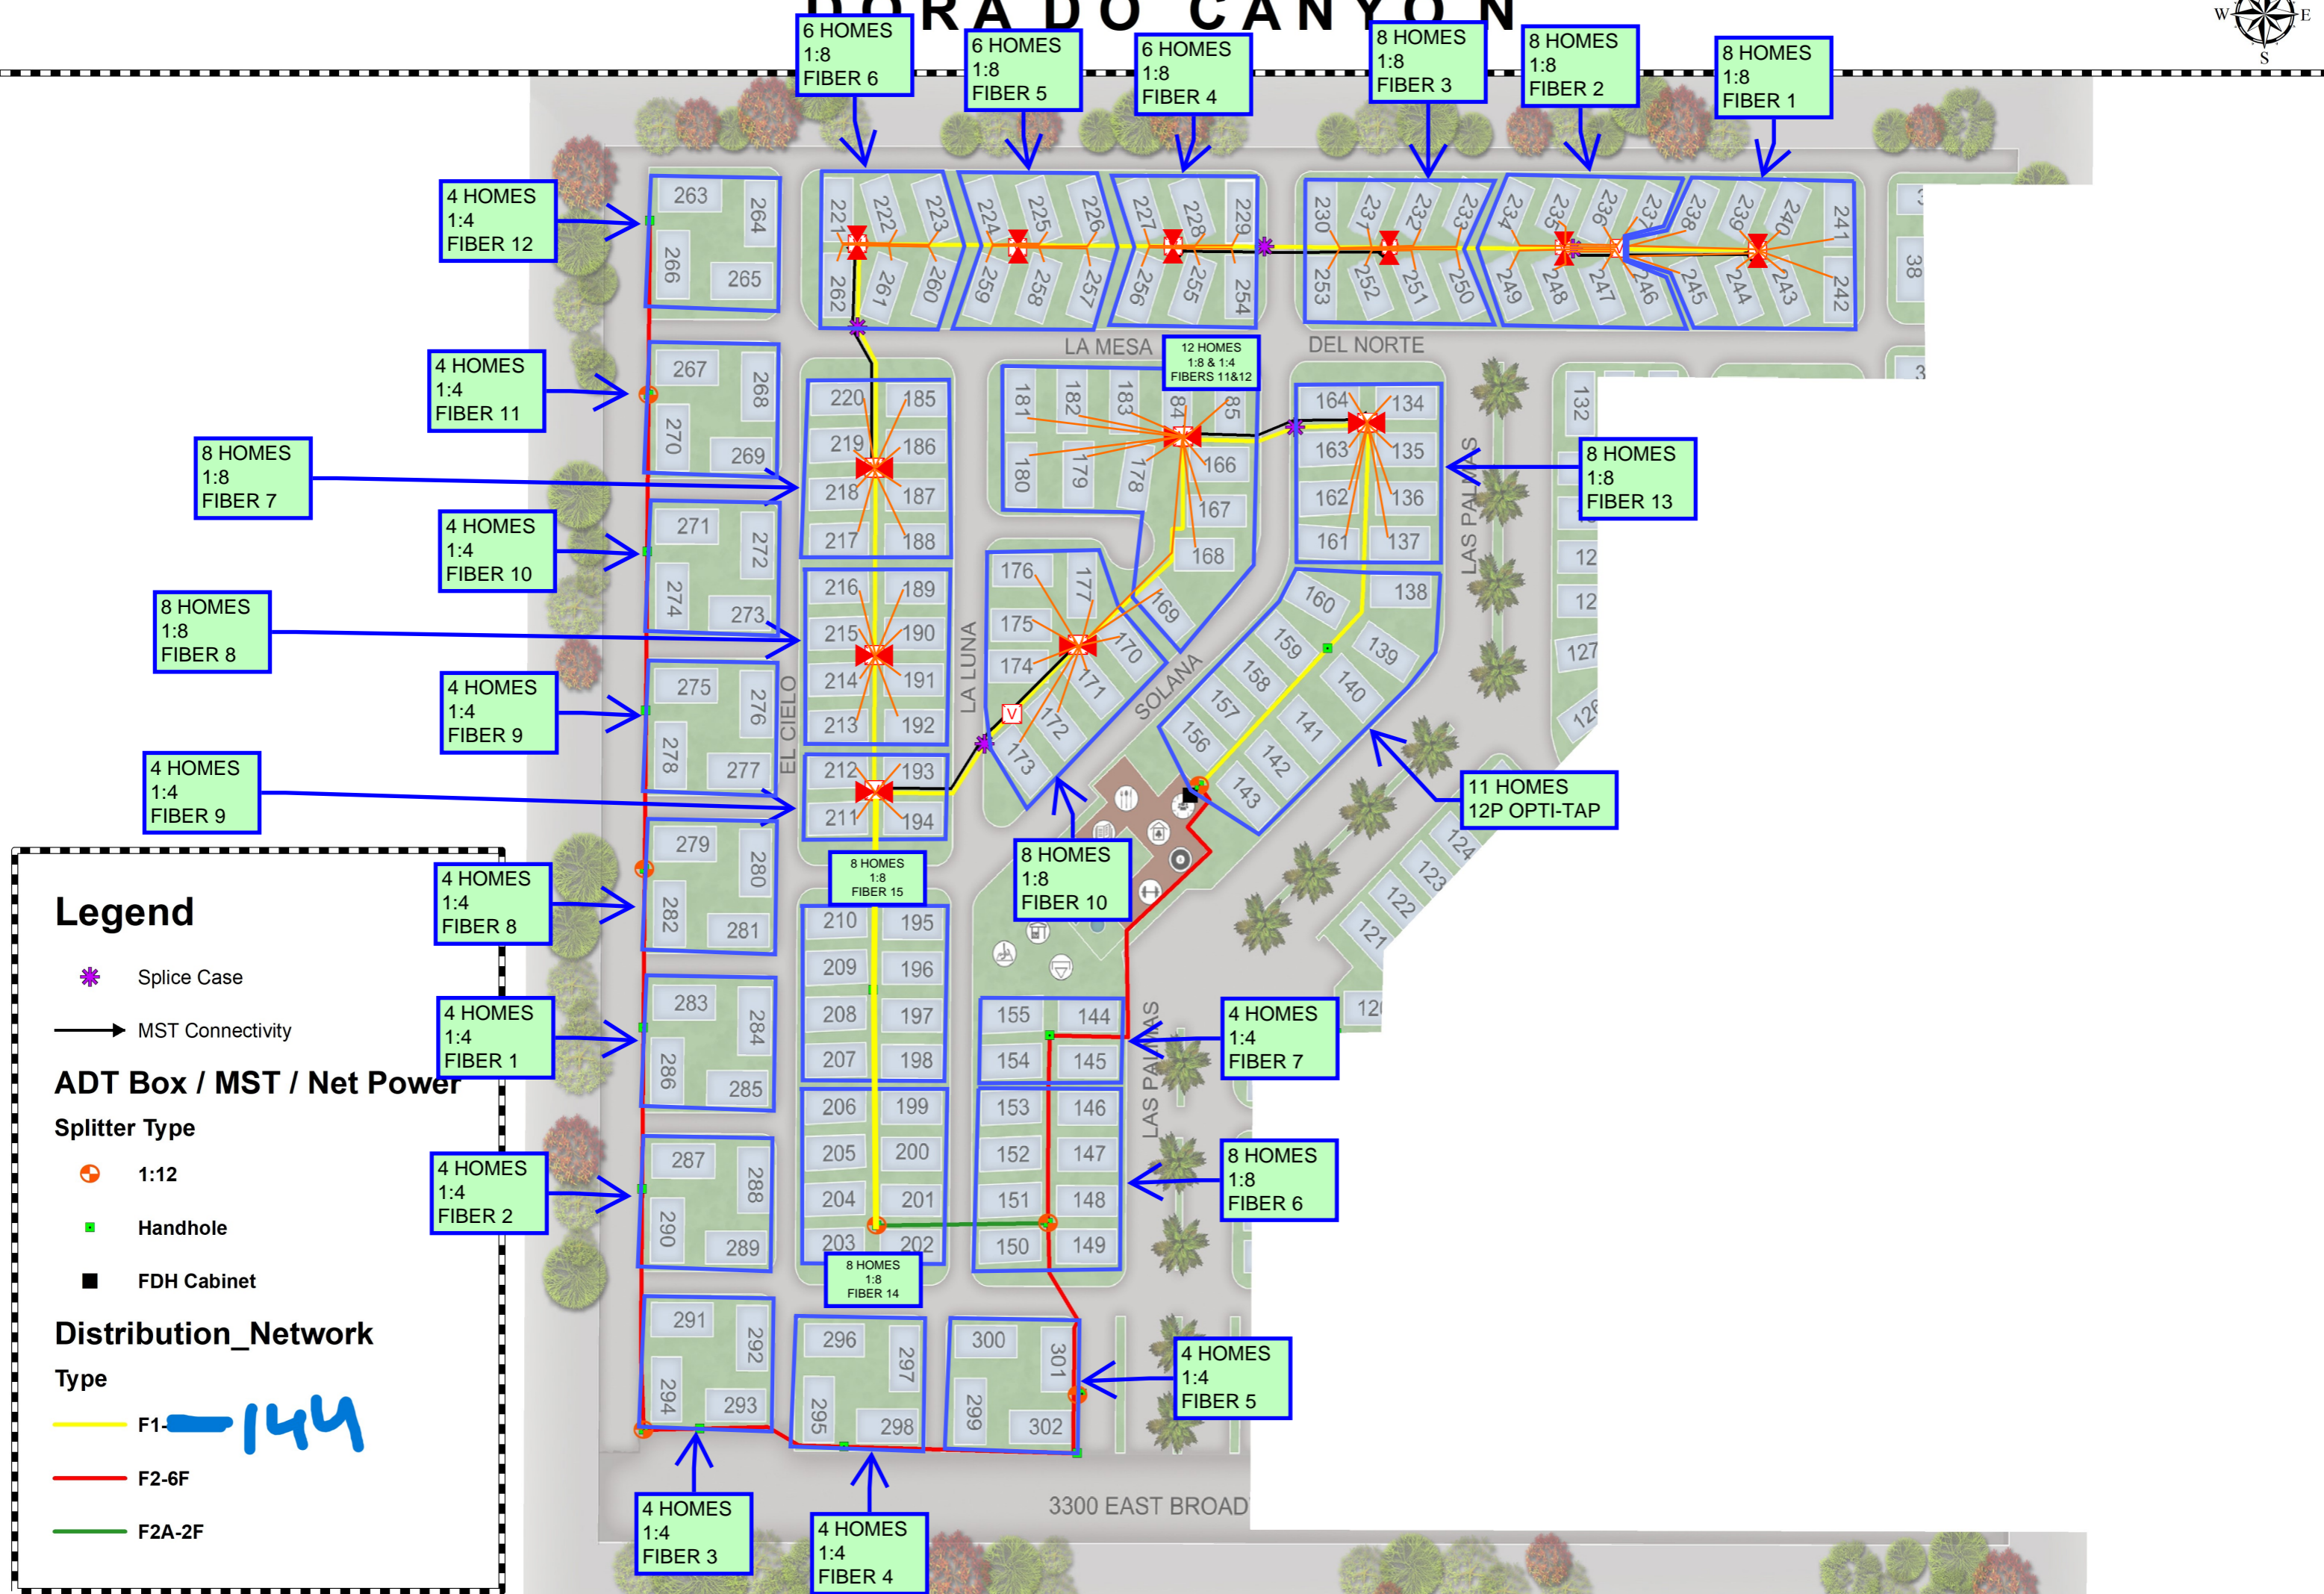


DORADO CANYON

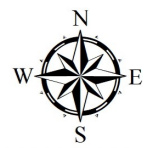

Legend

- Splice Case
- MST Connectivity

ADT Box / MST / Net Power

- Splitter Type**
- 1:12
 - Handhole
 - FDH Cabinet

Distribution_Network

- Type**
- F1-144
 - F2-6F
 - F2A-2F

6 HOMES
1:8
FIBER 6

6 HOMES
1:8
FIBER 5

6 HOMES
1:8
FIBER 4

8 HOMES
1:8
FIBER 3

8 HOMES
1:8
FIBER 2

8 HOMES
1:8
FIBER 1

4 HOMES
1:4
FIBER 12

4 HOMES
1:4
FIBER 11

8 HOMES
1:8
FIBER 7

4 HOMES
1:4
FIBER 10

8 HOMES
1:8
FIBER 8

4 HOMES
1:4
FIBER 9

4 HOMES
1:4
FIBER 9

4 HOMES
1:4
FIBER 8

4 HOMES
1:4
FIBER 1

4 HOMES
1:4
FIBER 2

8 HOMES
1:8
FIBER 15

8 HOMES
1:8
FIBER 10

4 HOMES
1:4
FIBER 7

8 HOMES
1:8
FIBER 6

4 HOMES
1:4
FIBER 5

4 HOMES
1:4
FIBER 3

4 HOMES
1:4
FIBER 4

12 HOMES
1:8 & 1:4
FIBERS 11&12

8 HOMES
1:8
FIBER 13

11 HOMES
12P OPTI-TAP